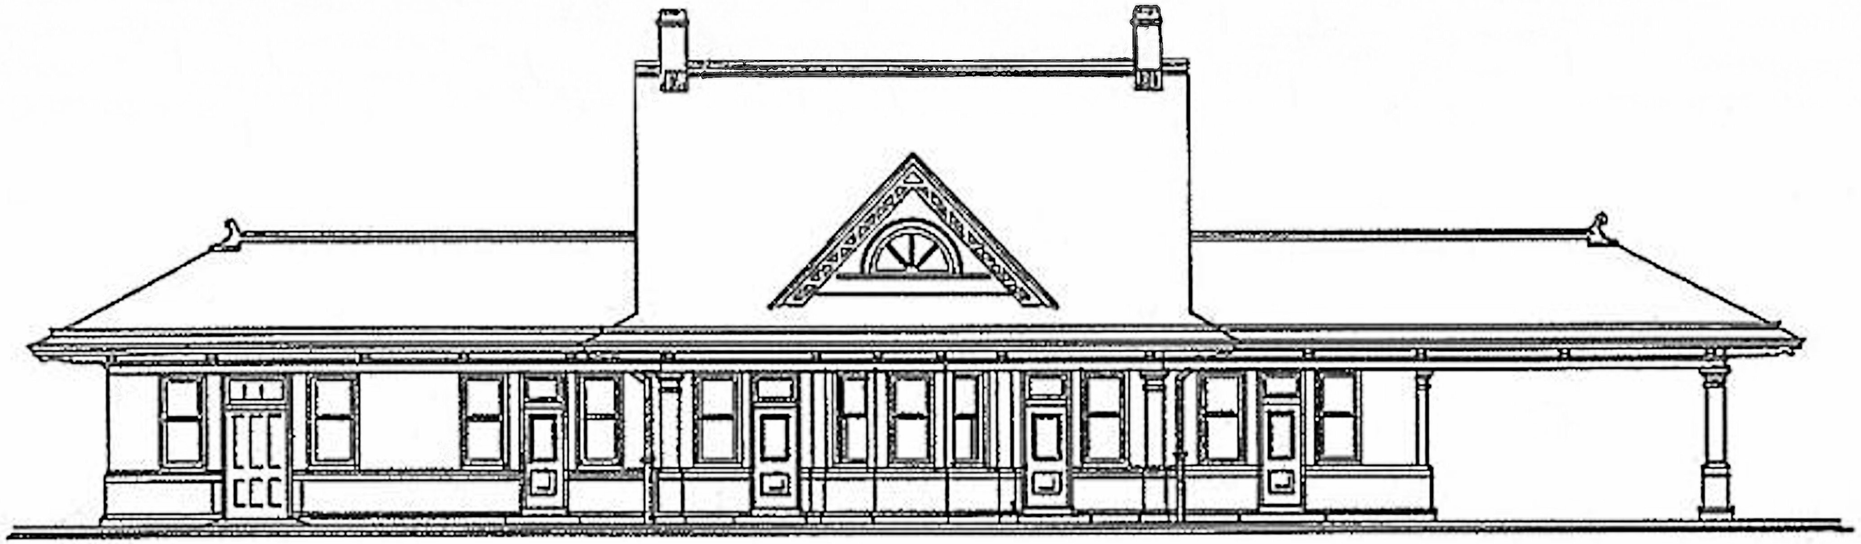

• TRACK SIDE ELEVATION •

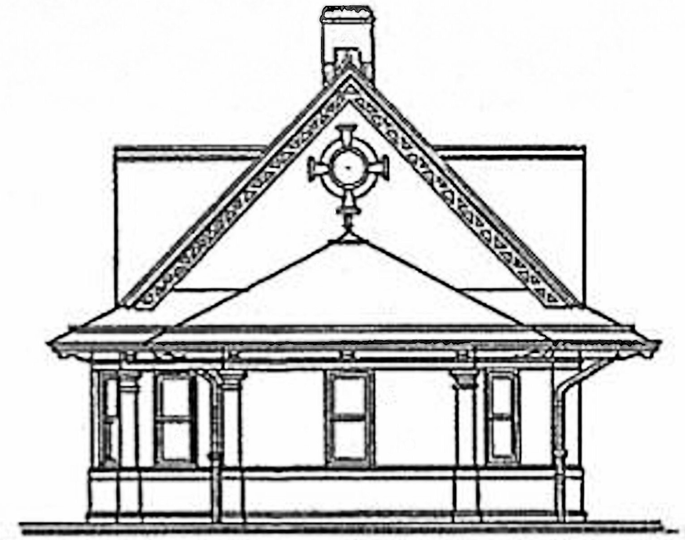

• END ELEVATION •

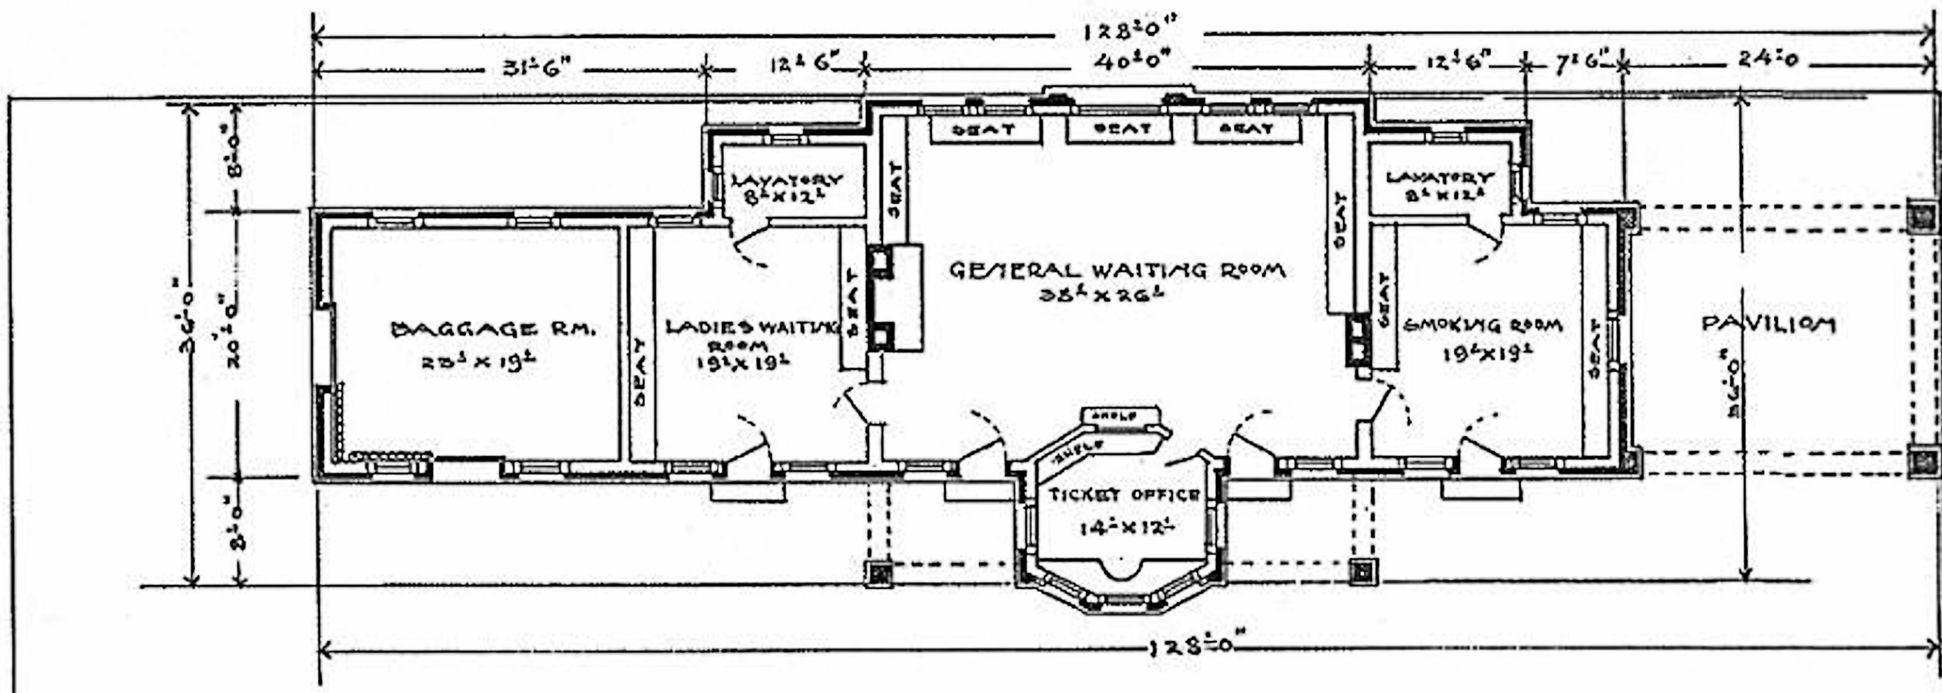

• PLAN •

C.M. & ST.P. RY
BRIDGE & BUILDING DEP'T.
36'x128' PASSENGER DEPOT.
• • AS BUILT AT • • •
CHIPPEWA FALLS, WIS.
CHICAGO, AUG. 30TH 1901
• • DRAWING No. A1077

J.U. METTENSTROM
• • • ARCHITECT.

C.F. LOWETH • • •
• • ENGR. & SUPT. B&B.

R. R. TRACK